

LAST REVISION: 12/21/10
 LAST PLOTTED: 12/21/10
 DRAWING SCALE: 1/2"=1'
 PLOT SCALE: 1=1

EQUIPMENT LAYOUT (ABOVE GRATING)


SCALE = 1/2" = 1'-0"

EQUIPMENT LAYOUT (BELOW GRATING)

SCALE = 1/2" = 1'-0"

AS BUILT DRAWING

DRAWING CONFIDENTIAL:
 THIS DRAWING AND ALL INFORMATION CONTAINED THEREON IS AND SHALL REMAIN THE PROPERTY OF A. ANDREANSKY, P.E., AS AN INSTRUMENT OF PROFESSIONAL SERVICE. THIS INFORMATION SHALL NOT BE USED WITHOUT THE FULL KNOWLEDGE AND PRIOR WRITTEN CONSENT OF A. ANDREANSKY, P.E.

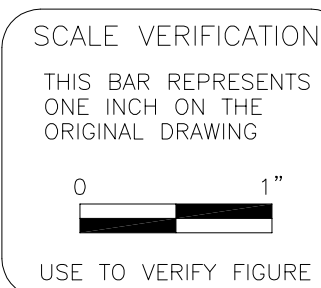

REVISION	DATE	DESCRIPTION	BY	APPROVED

ENGINEER OF RECORD:
 A. ANDREANSKY, P.E.
 FL REG. #39387

DATE SIGNED

CAD FILE: 1002171M1	SCALE: 1/2" = 1'-0"
DRAWN BY: A.A.	DATE: 11-25-10
CHECKED BY:	DATE:
APPROVED BY:	DATE:

AL ANDREANSKY, P.E.
 P.O. BOX 456
 PALM HARBOR, FLORIDA 34682-0456
 PHONE: (727) 460-8612, FAX: (727) 789-9565

TREATMENT BUILDING LAYOUT
 5902 SPORTSMAN CLUB ROAD
 JACKSONVILLE, FLORIDA 32219

PROJECT No.
 10021701.001

SHEET
 M1 of 1

JACKSONVILLE TERMINAL, CSX INTERMODAL, JACKSONVILLE, FLORIDA