


LAST REVISION: 07/02/11  
 LAST PLOTTED: 07/02/11  
 DRAWING SCALE: NTS  
 PLOT SCALE: 1=1



EXIST. SERVICE  
 (60\"/>

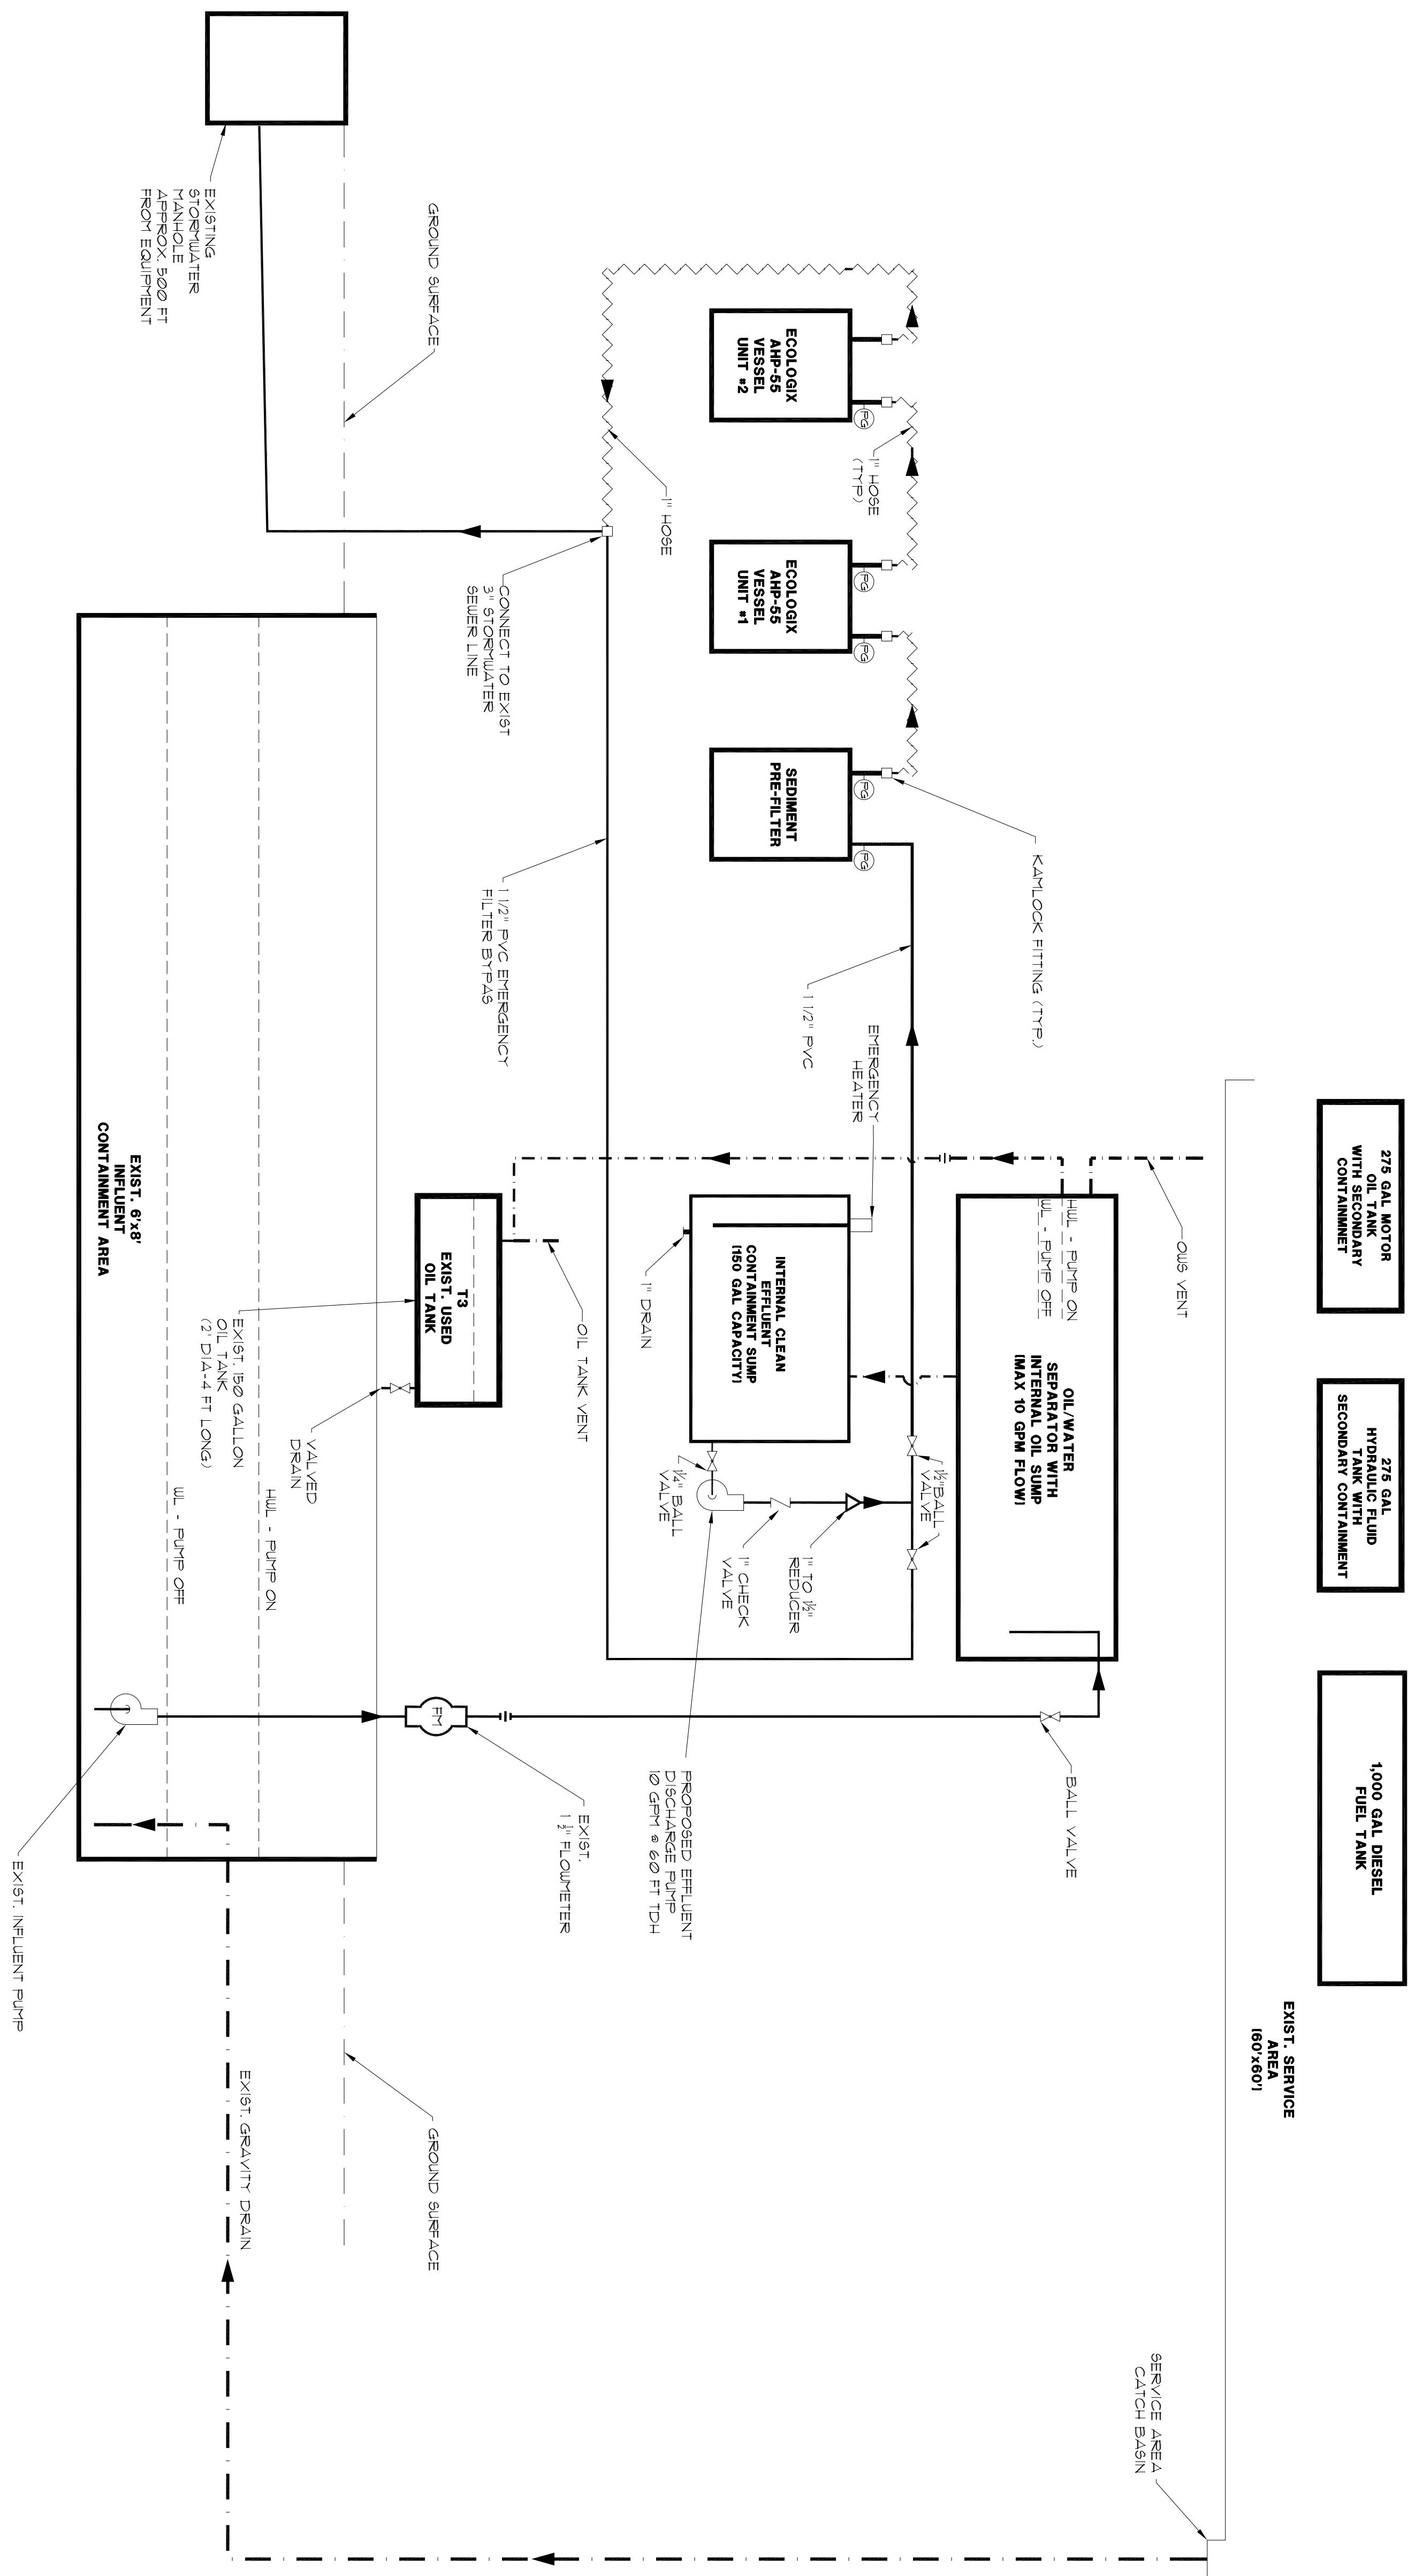

CSX INTERMODAL TERMINALS, INC.  
 TERMINAL DEVELOPMENT GROUP  
 JACKSONVILLE, FLORIDA

**AS-BUILT DRAWINGS**  
 I hereby certify that these "As-Built Drawings" reflect all significant changes and addenda approved during the construction process. They are based upon marked-up prints, drawings and other information furnished to the Engineer by the Contractor, and show the completed construction to the best of my knowledge and belief.

ENGINEER: \_\_\_\_\_ DATE: \_\_\_\_\_

PROJECT No.  
 10030201.001  
 SHEET  
**P1 of 1**

**PIPING SCHEMATIC**  
**3000 TREMONT AVENUE**  
**SAVANNAH, GEORGIA 31405**

**AL ANDREANSKY, P.E.**  
 P.O. BOX 456  
 PALM HARBOR, FLORIDA 34682-0456  
 PHONE: (727) 460-8612, FAX: (727) 789-9565

CAD FILE: 10030201M SCALE: NTS  
 DRAWN BY: A.A. DATE: 04-02-11  
 CHECKED BY: DATE:  
 APPROVED BY: DATE:

SCALE VERIFICATION  
 THIS BAR REPRESENTS ONE INCH ON THE ORIGINAL DRAWING  
 0 1"  
 USE TO VERIFY FIGURE

DRAWING CONFIDENTIAL:  
 THE DRAWING AND ALL INFORMATION CONTAINED THEREON IS AND SHALL REMAIN THE PROPERTY OF A. ANDREANSKY, P.E. AS AN INSTRUMENT OF PROFESSIONAL SERVICE. THIS INFORMATION SHALL NOT BE USED WITHOUT THE FULL KNOWLEDGE AND PRIOR WRITTEN CONSENT OF A. ANDREANSKY, P.E.

REV.	DATE	DESCRIPTION