


AS BUILT DRAWING

LAST REVISION: 12/21/10
 LAST PLOTTED: 12/21/10
 DRAWING SCALE: NA
 PLOT SCALE: 1=1

DRAWING CONFIDENTIAL:
 THIS DRAWING AND ALL INFORMATION
 CONTAINED THEREON IS AND SHALL
 REMAIN THE PROPERTY OF
 A. ANDREANSKY, P.E., AS
 AN INSTRUMENT OF PROFESSIONAL
 SERVICE. THIS INFORMATION SHALL
 NOT BE USED WITHOUT THE FULL
 KNOWLEDGE AND PRIOR WRITTEN
 CONSENT OF A. ANDREANSKY, P.E.

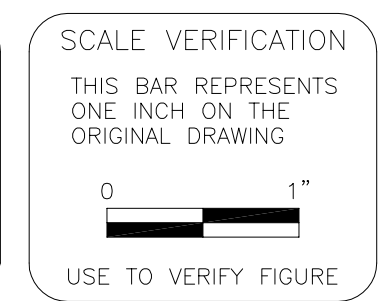

REVISION	DATE	DESCRIPTION	BY	APPROVED

ENGINEER OF RECORD:
 AL ANDREANSKY, P.E. DATE: 05-07-10
 FLA. REG. #39387 DATE SIGNED:

CAD FILE: 10042801P1 SCALE: NA
 DRAWN BY: A.A. DATE: 05-07-10
 CHECKED BY: DATE:
 APPROVED BY: DATE:

AL ANDREANSKY, P.E.
 P.O. BOX 456
 PALM HARBOR, FLORIDA 34682-0456
 PHONE: 17271 460-8612, FAX: 17271 789-9565

EXISTING OWS PIPING SCHEMATIC
 8850 ATLANTIC AVENUE
 ORLANDO, FLORIDA 32824

PROJECT No.
 10042801.001
 SHEET
 P1 of 3

ORLANDO TERMINAL, CSX INTERMODAL, JACKSONVILLE, FLORIDA