


HVAC PLAN
SCALE= 1/2"=1'-0"

MISC. NOTES

- BUILDING HEATING AND VENTILATION WILL MEET REQUIREMENTS OF 2009 OMC, 2009 UPDATES.
- MINIMUM VENTILATION REQUIRED 0.05 CFM/SQ FT (WAREHOUSE).

LAST REVISION: 01/04/12
LAST PLOTTED: 01/04/12
DRAWING SCALE: 1/2"=1'
PLOT SCALE: 1=1

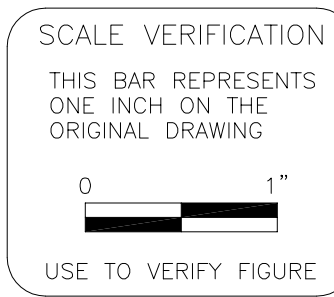

REVISION	DATE	DESCRIPTION	BY	APPROVED
1	12/29/11	AS BUILT REVISIONS	AA	

ENGINEER OF RECORD:

AL ANDREANSKY, P.E.
OHIO REG. #75847

DATE SIGNED

CAD FILE: 110222401M SCALE: 1/2"=1'-0"

DRAWN BY: A.A. DATE: 03-19-11

CHECKED BY: DATE:

APPROVED BY: DATE:

AL ANDREANSKY, P.E.
P.O. BOX 456
PALM HARBOR, FLORIDA 34682-0456
PHONE: 17271 460-8612, FAX: 17271 789-9565

BUILDING HVAC PLAN

2149 WESTERN AVENUE
CINCINNATI, OHIO 45214

PROJECT No. 11022401.001

SHEET

V1 of 1

[CSX]

CSX INTERMODAL TERMINALS, INC.
TERMINAL DEVELOPMENT GROUP
JACKSONVILLE, FLORIDA

AS-BUILT DRAWINGS

I hereby certify that these "As-Built" drawings reflect the construction process. They are based upon material furnished to me by the Contractor and show the completed construction to the best of my knowledge and belief.

ENGINEER: _____ DATE: _____

ALFONZ ANDREANSKY
E-75847
REGISTERED PROFESSIONAL ENGINEER
STATE OF OHIO

CINCINNATI TERMINAL, CSX INTERMODAL, JACKSONVILLE, FLORIDA