



LAST REVISION: 01/06/12  
 LAST PLOTTED: 01/06/12  
 DRAWING SCALE: 1/8"=1'  
 PLOT SCALE: 1=1

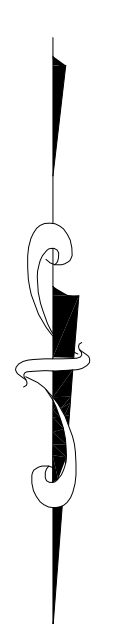

**PRE-CONSTRUCTION EQUIPMENT LAYOUT**

SCALE: 1/8"=1'-0"

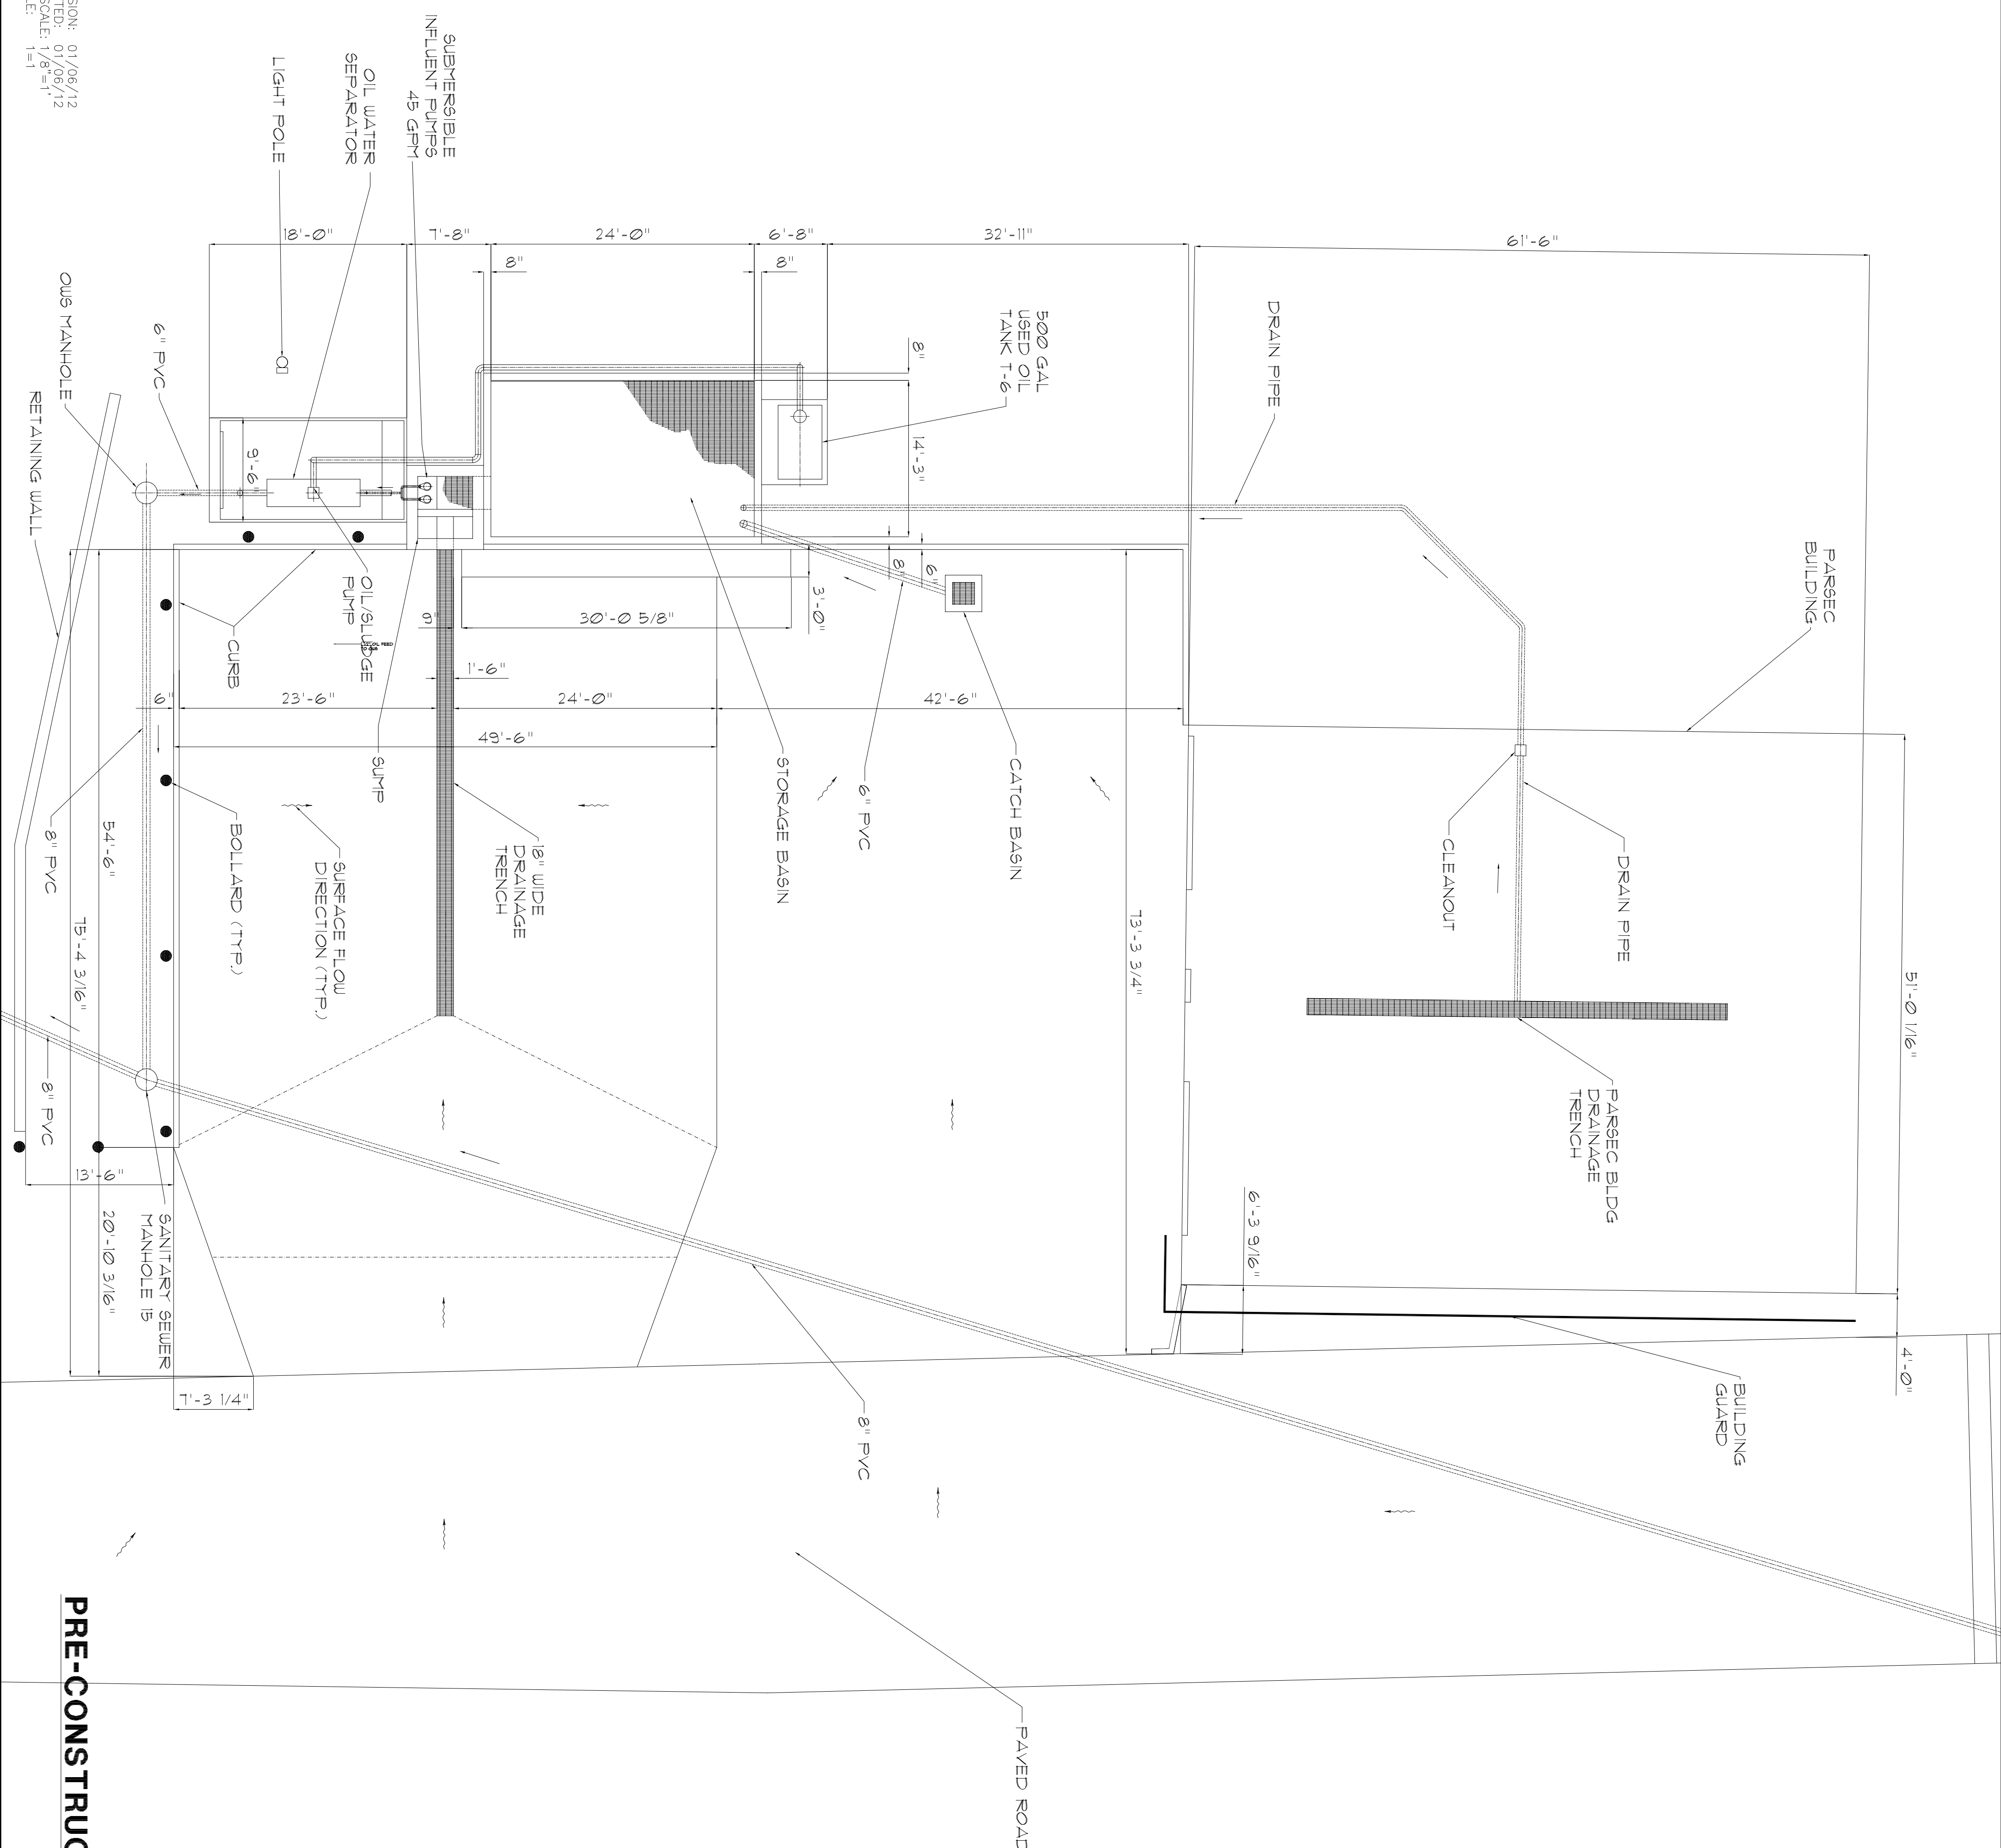

CSX INTERMODAL TERMINALS, INC.  
 TERMINAL DEVELOPMENT GROUP  
 JACKSONVILLE, FLORIDA

**AS-BUILT DRAWINGS**

I hereby certify that these "As-Built Drawings" reflect all significant changes and addenda approved during the construction process. They are based upon marked-up prints, drawings and other information furnished to the engineer by the Contractor, and show the completed construction to the best of my knowledge and belief.

ENGINEER: \_\_\_\_\_ DATE: \_\_\_\_\_

|                             |   |
|-----------------------------|---|
| PROJECT No.<br>11062701.001 | <b>PRE-CONSTRUCTION EQUIPMENT LAYOUT</b>              |
| SHEET                       | <b>501 S COUNTY ROAD 800E<br/>AVON, INDIANA 46123</b> |
| M1 of 3                     |   |

**AL ANDREANSKY, P.E.**  
 P.O. BOX 456  
 PALM HARBOR, FLORIDA 34682-0456  
 PHONE: (727) 460-8612, FAX: (727) 789-9565

|                     |                |
|---------------------|----------------|
| CAD FILE: 11062701M | SCALE: 1/8"=1' |
| DRAWN BY: A.A.      | DATE: 07-09-11 |
| CHECKED BY:         | DATE:          |
| APPROVED BY:        | DATE:          |

**SCALE VERIFICATION**  
 THIS BAR REPRESENTS ONE INCH ON THE ORIGINAL DRAWING

USE TO VERIFY FIGURE

**DRAWING CONFIDENTIAL:**  
 THIS DRAWING AND ALL INFORMATION CONTAINED THEREON IS AND SHALL REMAIN THE PROPERTY OF A. ANDREANSKY, P.E. AS AN INSTRUMENT OF PROFESSIONAL SERVICE. THIS INFORMATION SHALL NOT BE USED WITHOUT THE FULL KNOWLEDGE AND PRIOR WRITTEN CONSENT OF A. ANDREANSKY, P.E.

| REV. | DATE     | DESCRIPTION                |
|------|----------|----------------------------|
| 1    | 07/09/11 | REVISION PER JACQUS HARGUP |
| 2    | 02/01/12 | AS BUILT REVISIONS         |
|      |          |                            |
|      |          |                            |