


LAST REVISION: 01/09/12  
 LAST PLOTTED: 12/27/11  
 DRAWING SCALE: 1/8"=1'  
 PLOT SCALE: 1=1

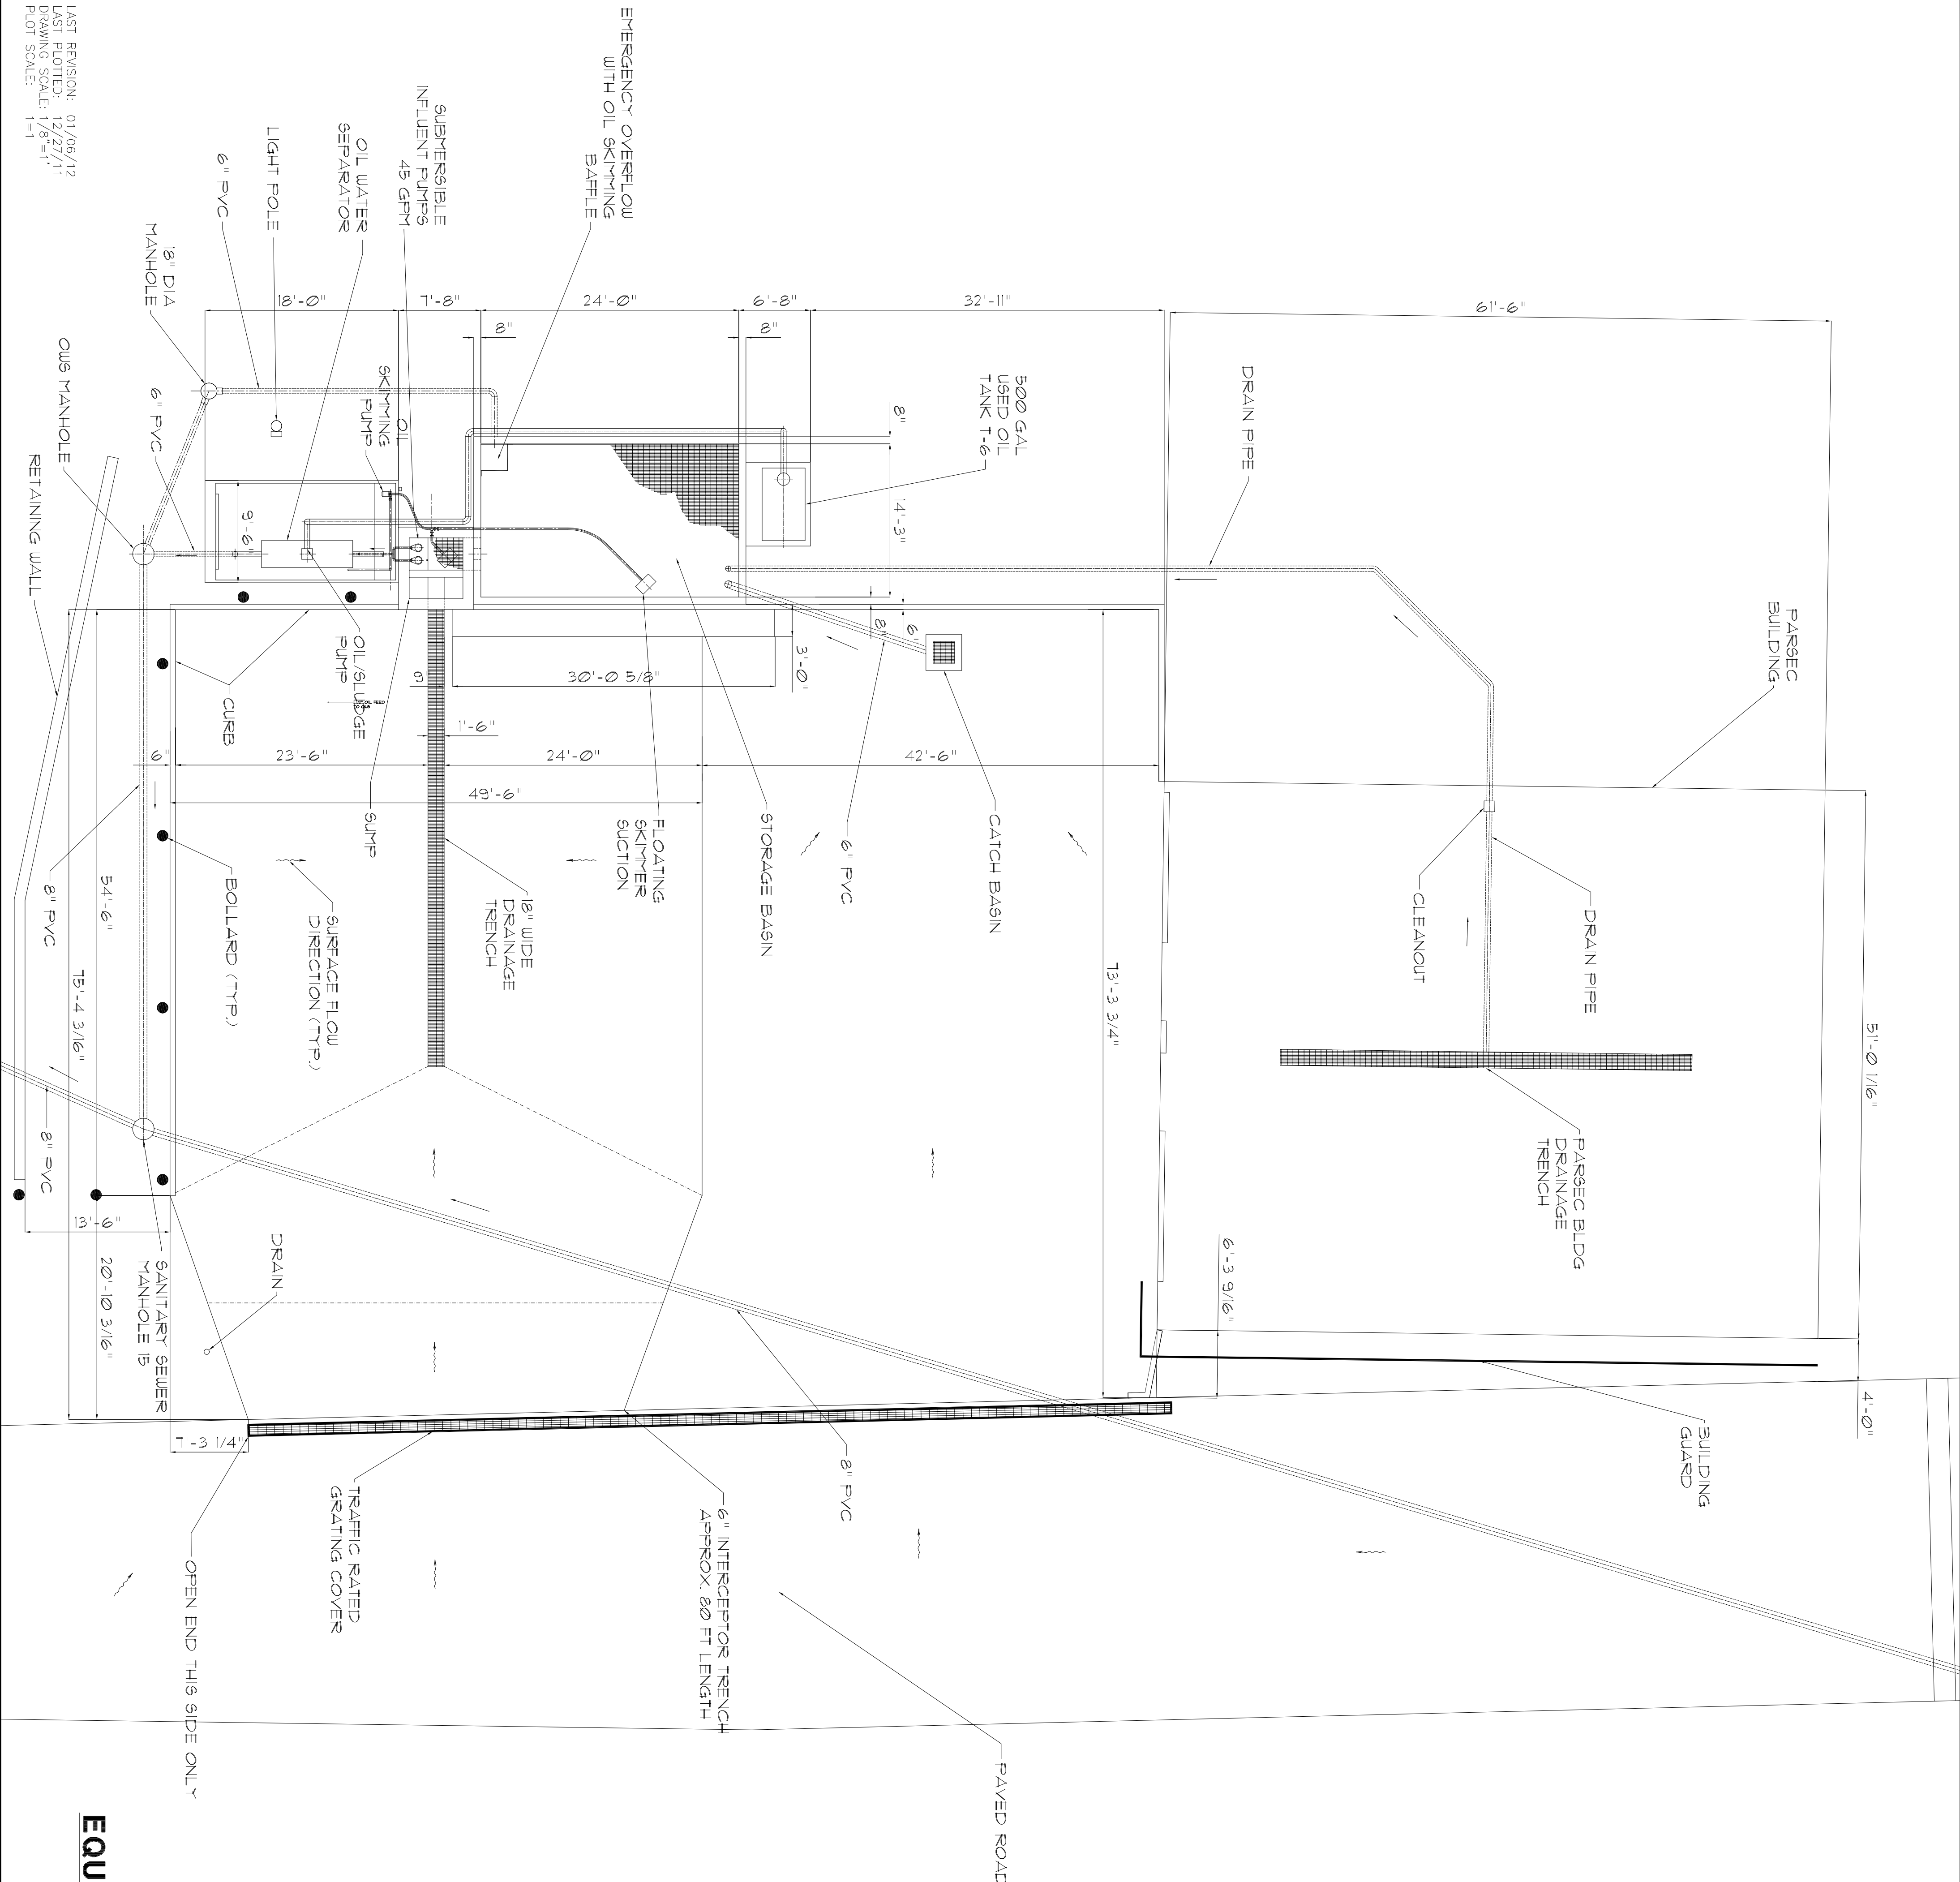

**EQUIPMENT LAYOUT**

SCALE: 1/8"=1'-0"



CSX INTERMODAL TERMINALS, INC.  
 TERMINAL DEVELOPMENT GROUP  
 JACKSONVILLE, FLORIDA


AS-BUILT DRAWINGS  
 I hereby certify that these "As-Built Drawings" reflect all significant changes and addenda approved during the construction process. They are based upon marked-up prints, drawings and other information furnished to the engineer by the Contractor, and show the completed construction to the best of my knowledge and belief.  
 ENGINEER: \_\_\_\_\_ DATE: \_\_\_\_\_

PROJECT No. 11062701.001  
 SHEET M2 of 3

**EQUIPMENT LAYOUT**  
 501 S COUNTY ROAD 800E  
 AVON, INDIANA 46123

**AL ANDREANSKY, P.E.**  
 P.O. BOX 456  
 PALM HARBOR, FLORIDA 34682-0456  
 PHONE: (727) 460-8612, FAX: (727) 789-9565

CAD FILE: 11062701M SCALE: 1/8"=1'  
 DRAWN BY: A.A. DATE: 07-09-11  
 CHECKED BY: DATE:  
 APPROVED BY: DATE:

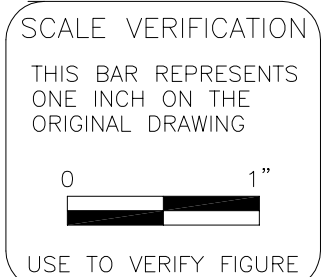

DRAWING CONFIDENTIAL: THIS DRAWING AND ALL INFORMATION CONTAINED THEREIN IS AND SHALL REMAIN THE PROPERTY OF AL ANDREANSKY, P.E. AS AN INSTRUMENT OF PROFESSIONAL SERVICE. THIS INFORMATION SHALL NOT BE USED WITHOUT THE FULL KNOWLEDGE AND PRIOR WRITTEN CONSENT OF AL ANDREANSKY, P.E.

REV.	DATE	DESCRIPTION
1	03/11	REVISION PER ARCADIS MARKUP
2	02/10	AS BUILT REVISIONS