



**A**  
**CROSS SECTION**  
 SCALE: 3/8"=1'-0"

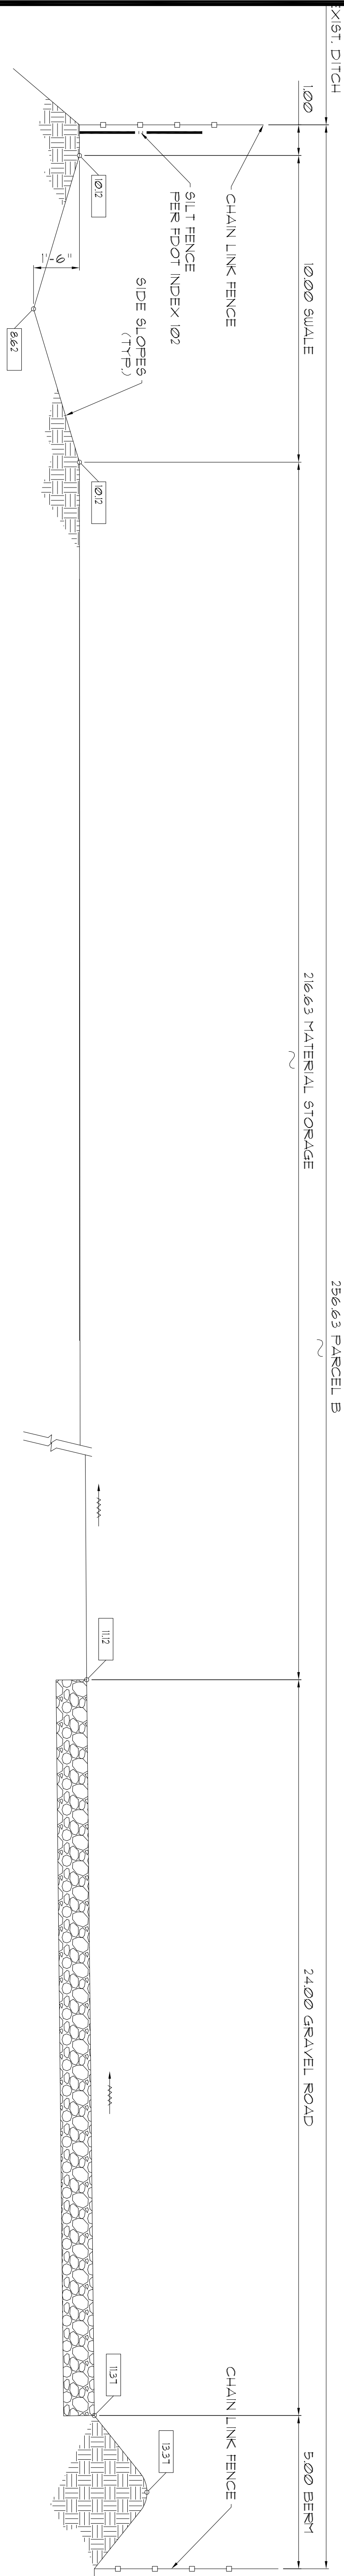

**B**  
**CROSS SECTION**  
 SCALE: 3/8"=1'-0"

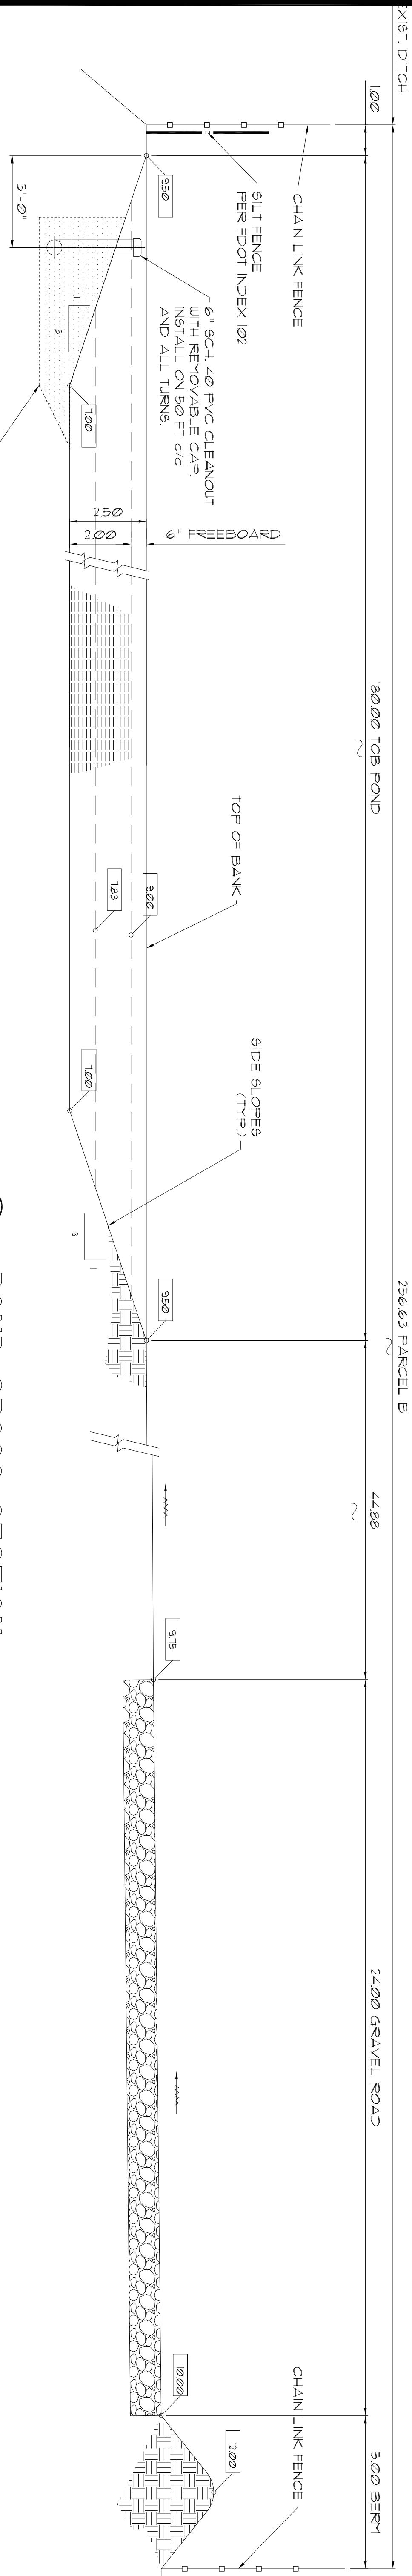

**C**  
**POND CROSS SECTION**  
 SCALE: 3/8"=1'-0"

LAST REVISION: 03/23/12  
 LAST PLOTTED: 03/23/12  
 DRAWING SCALE: 3/8"=1'-0"  
 PLOT SCALE: 1"=1'

**DRAWING CONFIDENTIAL:**  
 THIS DRAWING AND ALL INFORMATION CONTAINED HEREON IS AND SHALL BE THE PROPERTY OF TITAN AMERICA. IT IS TO BE KEPT IN CONFIDENTIALITY AND IS NOT TO BE USED WITHOUT THE FULL KNOWLEDGE AND PRIOR WRITTEN CONSENT OF TITAN AMERICA, P.L.C.

**SCALE VERIFICATION**  
 THIS BAR REPRESENTS THE ORIGINAL DRAWING  
 0' 1'

REVISION	DATE	DESCRIPTION	BY	APPROVED

**ENGINEER OF RECORD:**  
 AL ANDREANSKY, P.E.  
 F.L.A. REG. #39387

CAD FILE: 11082901ABD	SCALE: 3/8"=1'-0"
DRAWN BY: A.A.	DATE: 9-27-11
CHECKED BY:	DATE:
APPROVED BY:	DATE:

**AL ANDREANSKY, P.E.**  
 P.O. BOX 456  
 PALM HARBOR, FLORIDA 34682-0456  
 PHONE: (727) 460-8612, FAX: (727) 789-9565

**SITE SECTIONS**  
 MARITIME BLVD  
 TAMPA, FLORIDA

**AS-BUILT DRAWINGS**  
 I hereby certify that these "As-Built Drawings" reflect all significant changes and conditions approved during the construction process. They are based upon marked-up site drawings and other information furnished to the Engineer by the Contractor, and show the completed construction to the best of my knowledge and belief.  
 ENGINEER: \_\_\_\_\_ DATE: \_\_\_\_\_

PROJECT NO. 11082901.001  
 SHEET D1 OF 2