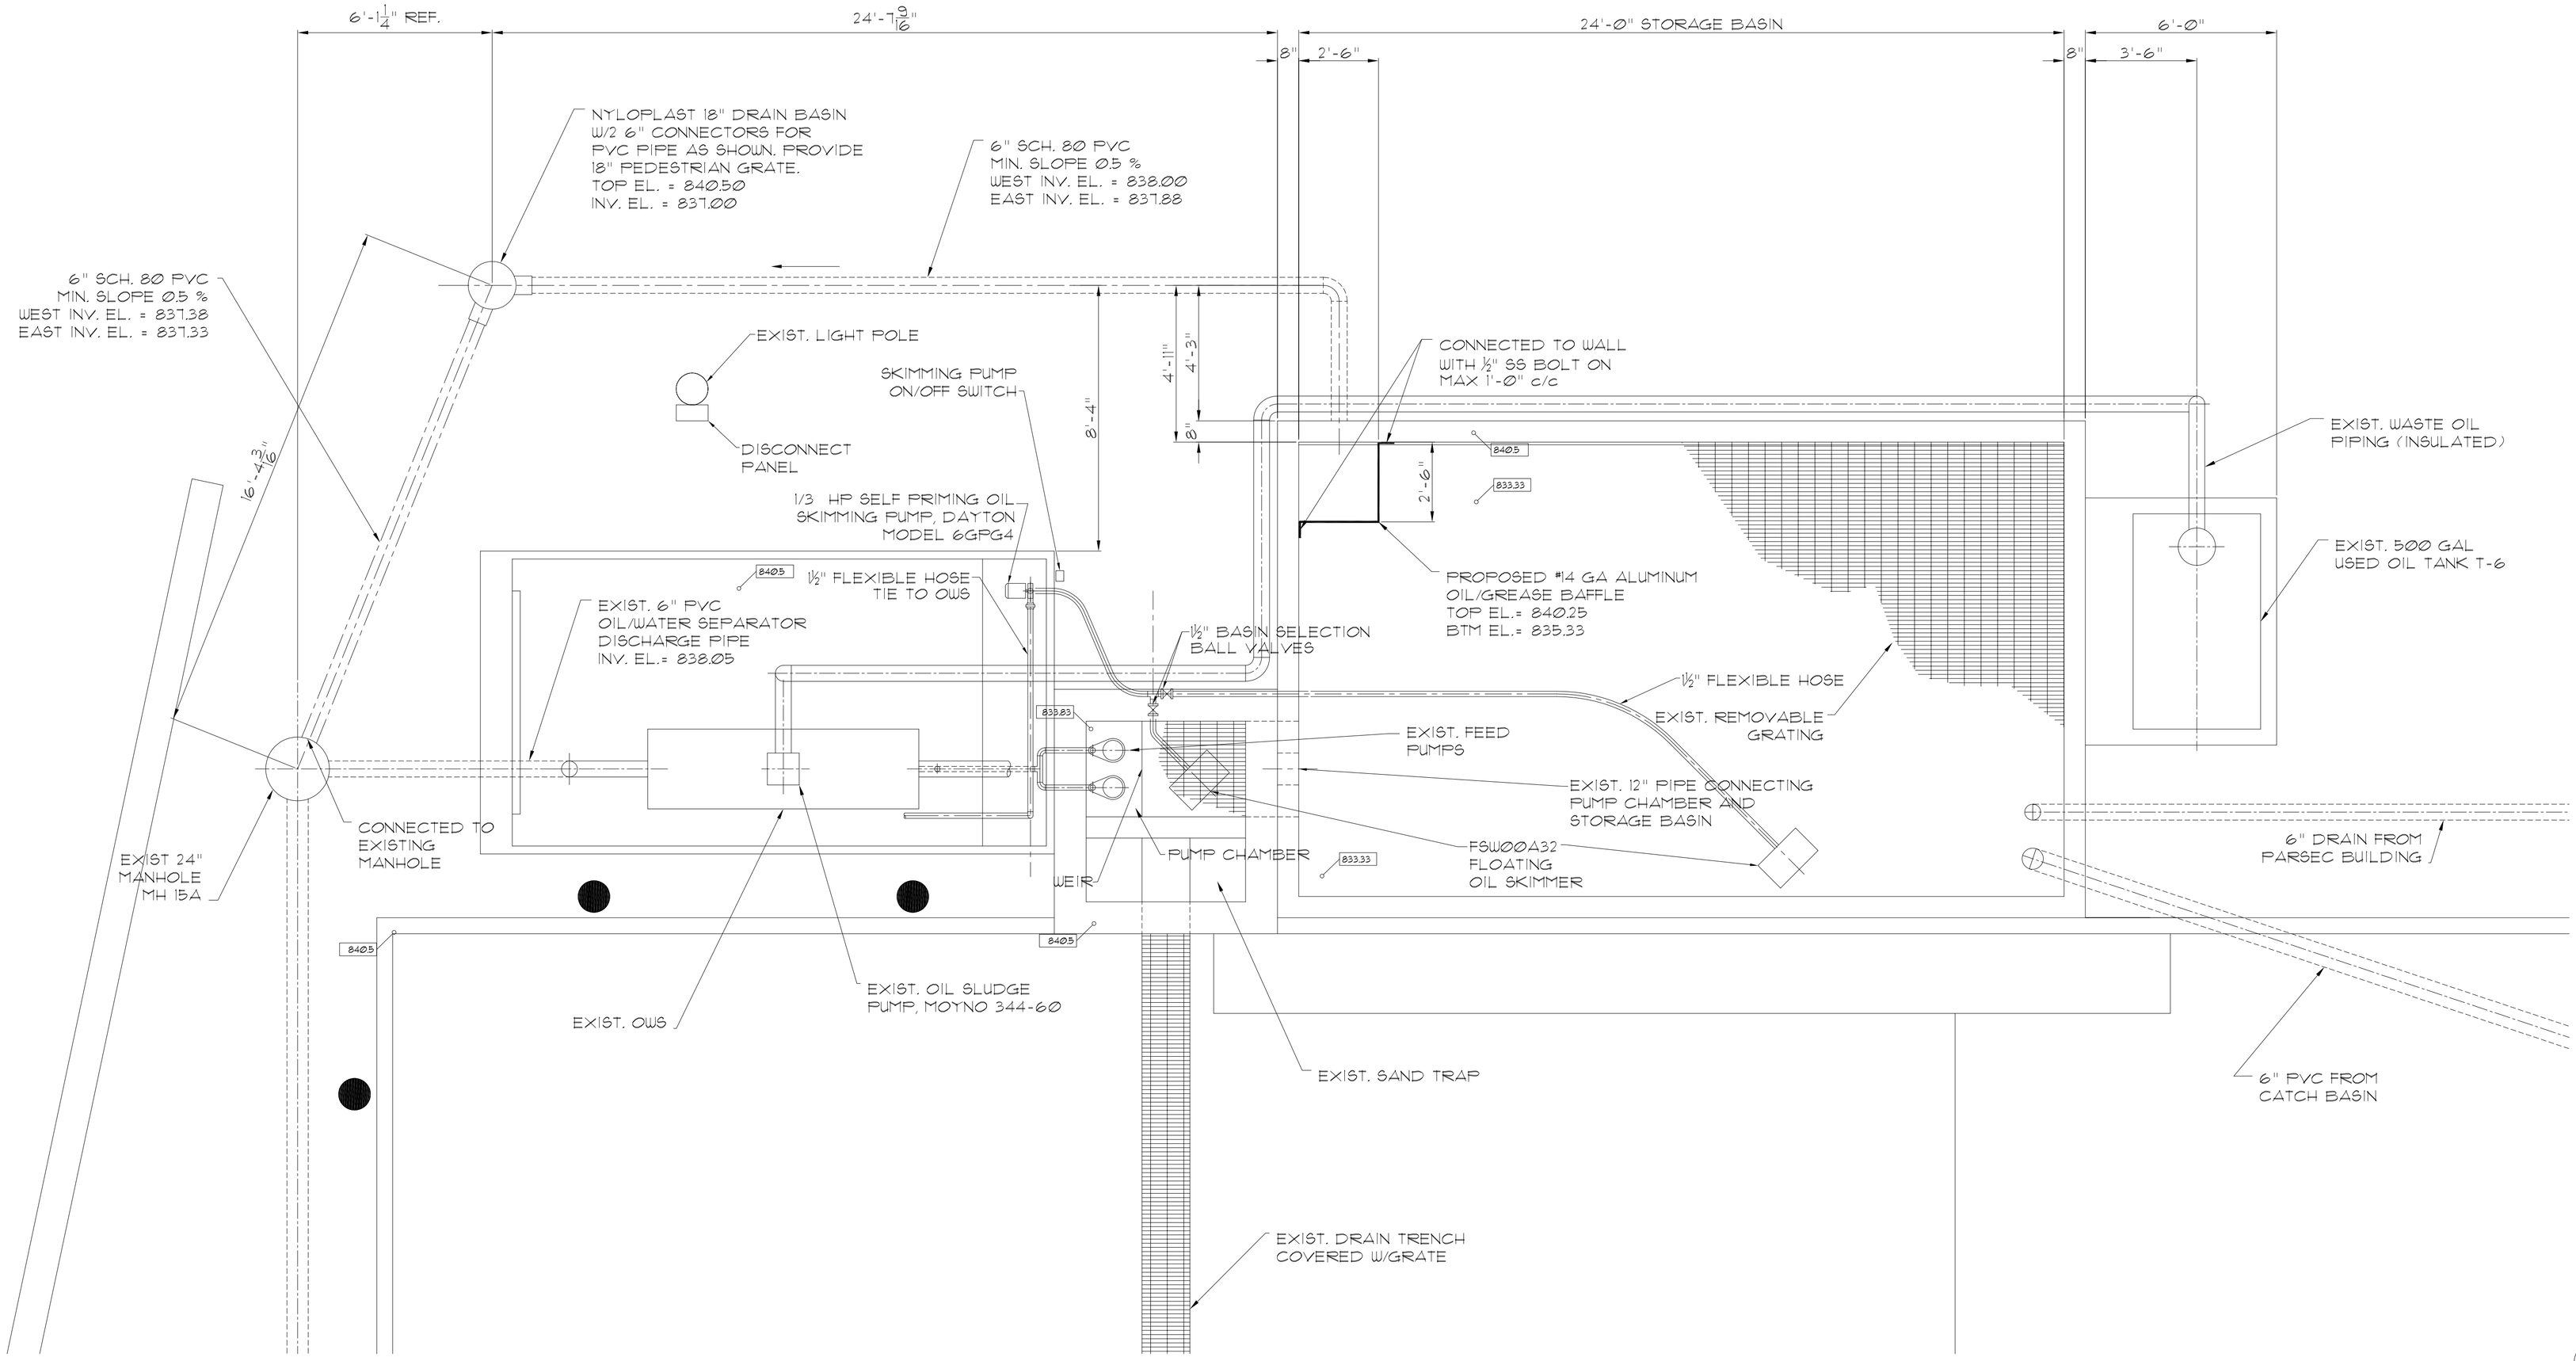

EQUIPMENT LAYOUT (ENLARGED VIEW)

SCALE: 3/8"=1'-0"

LAST REVISION: 01/06/12
LAST PLOTTED: 01/06/12
DRAWING SCALE: 3/8"=1'
PLOT SCALE: 1=1

CSX INTERMODAL TERMINALS, INC.
TERMINAL DEVELOPMENT GROUP
JACKSONVILLE, FLORIDA

AS-BUILT DRAWINGS
I hereby certify that these "As-Built Drawings" reflect all significant changes and adjustments approved during the construction process. They are based upon marked-up prints, drawings and other information furnished to the Engineer by the Contractor, and show the completed construction to the best of my knowledge and belief.
ENGINEER: _____ DATE: _____

REV.	DATE	DESCRIPTION
1	12/2/11	AS BUILT REVISIONS

DRAWING CONFIDENTIAL: THIS DRAWING AND ALL INFORMATION CONTAINED THEREON IS AND SHALL REMAIN THE PROPERTY OF A. ANDREANSKY, P.E. AS AN INSTRUMENT OF PROFESSIONAL SERVICE. THIS INFORMATION SHALL NOT BE USED WITHOUT THE FULL KNOWLEDGE AND PRIOR WRITTEN CONSENT OF AL ANDREANSKY, P.E.

SCALE VERIFICATION
THIS BAR REPRESENTS ONE INCH ON THE ORIGINAL DRAWING
0 1"
USE TO VERIFY FIGURE

CAD FILE: 11062701M
SCALE: 3/8"=1'
DRAWN BY: A.A.
DATE: 11-02-11
CHECKED BY:
DATE:
APPROVED BY:
DATE:

AL ANDREANSKY, P.E.
P.O. BOX 456
PALM HARBOR, FLORIDA 34682-0456
PHONE: (727) 460-8612, FAX: (727) 789-9565

EQUIPMENT LAYOUT
501 S COUNTY ROAD 800E
AVON, INDIANA 46123

PROJECT No. 11062701.001
SHEET M3 of 3

WASTEWATER TREATMENT IMPROVEMENT, INDIANAPOLIS TERMINAL, CSX INTERMODAL, JACKSONVILLE, FLORIDA