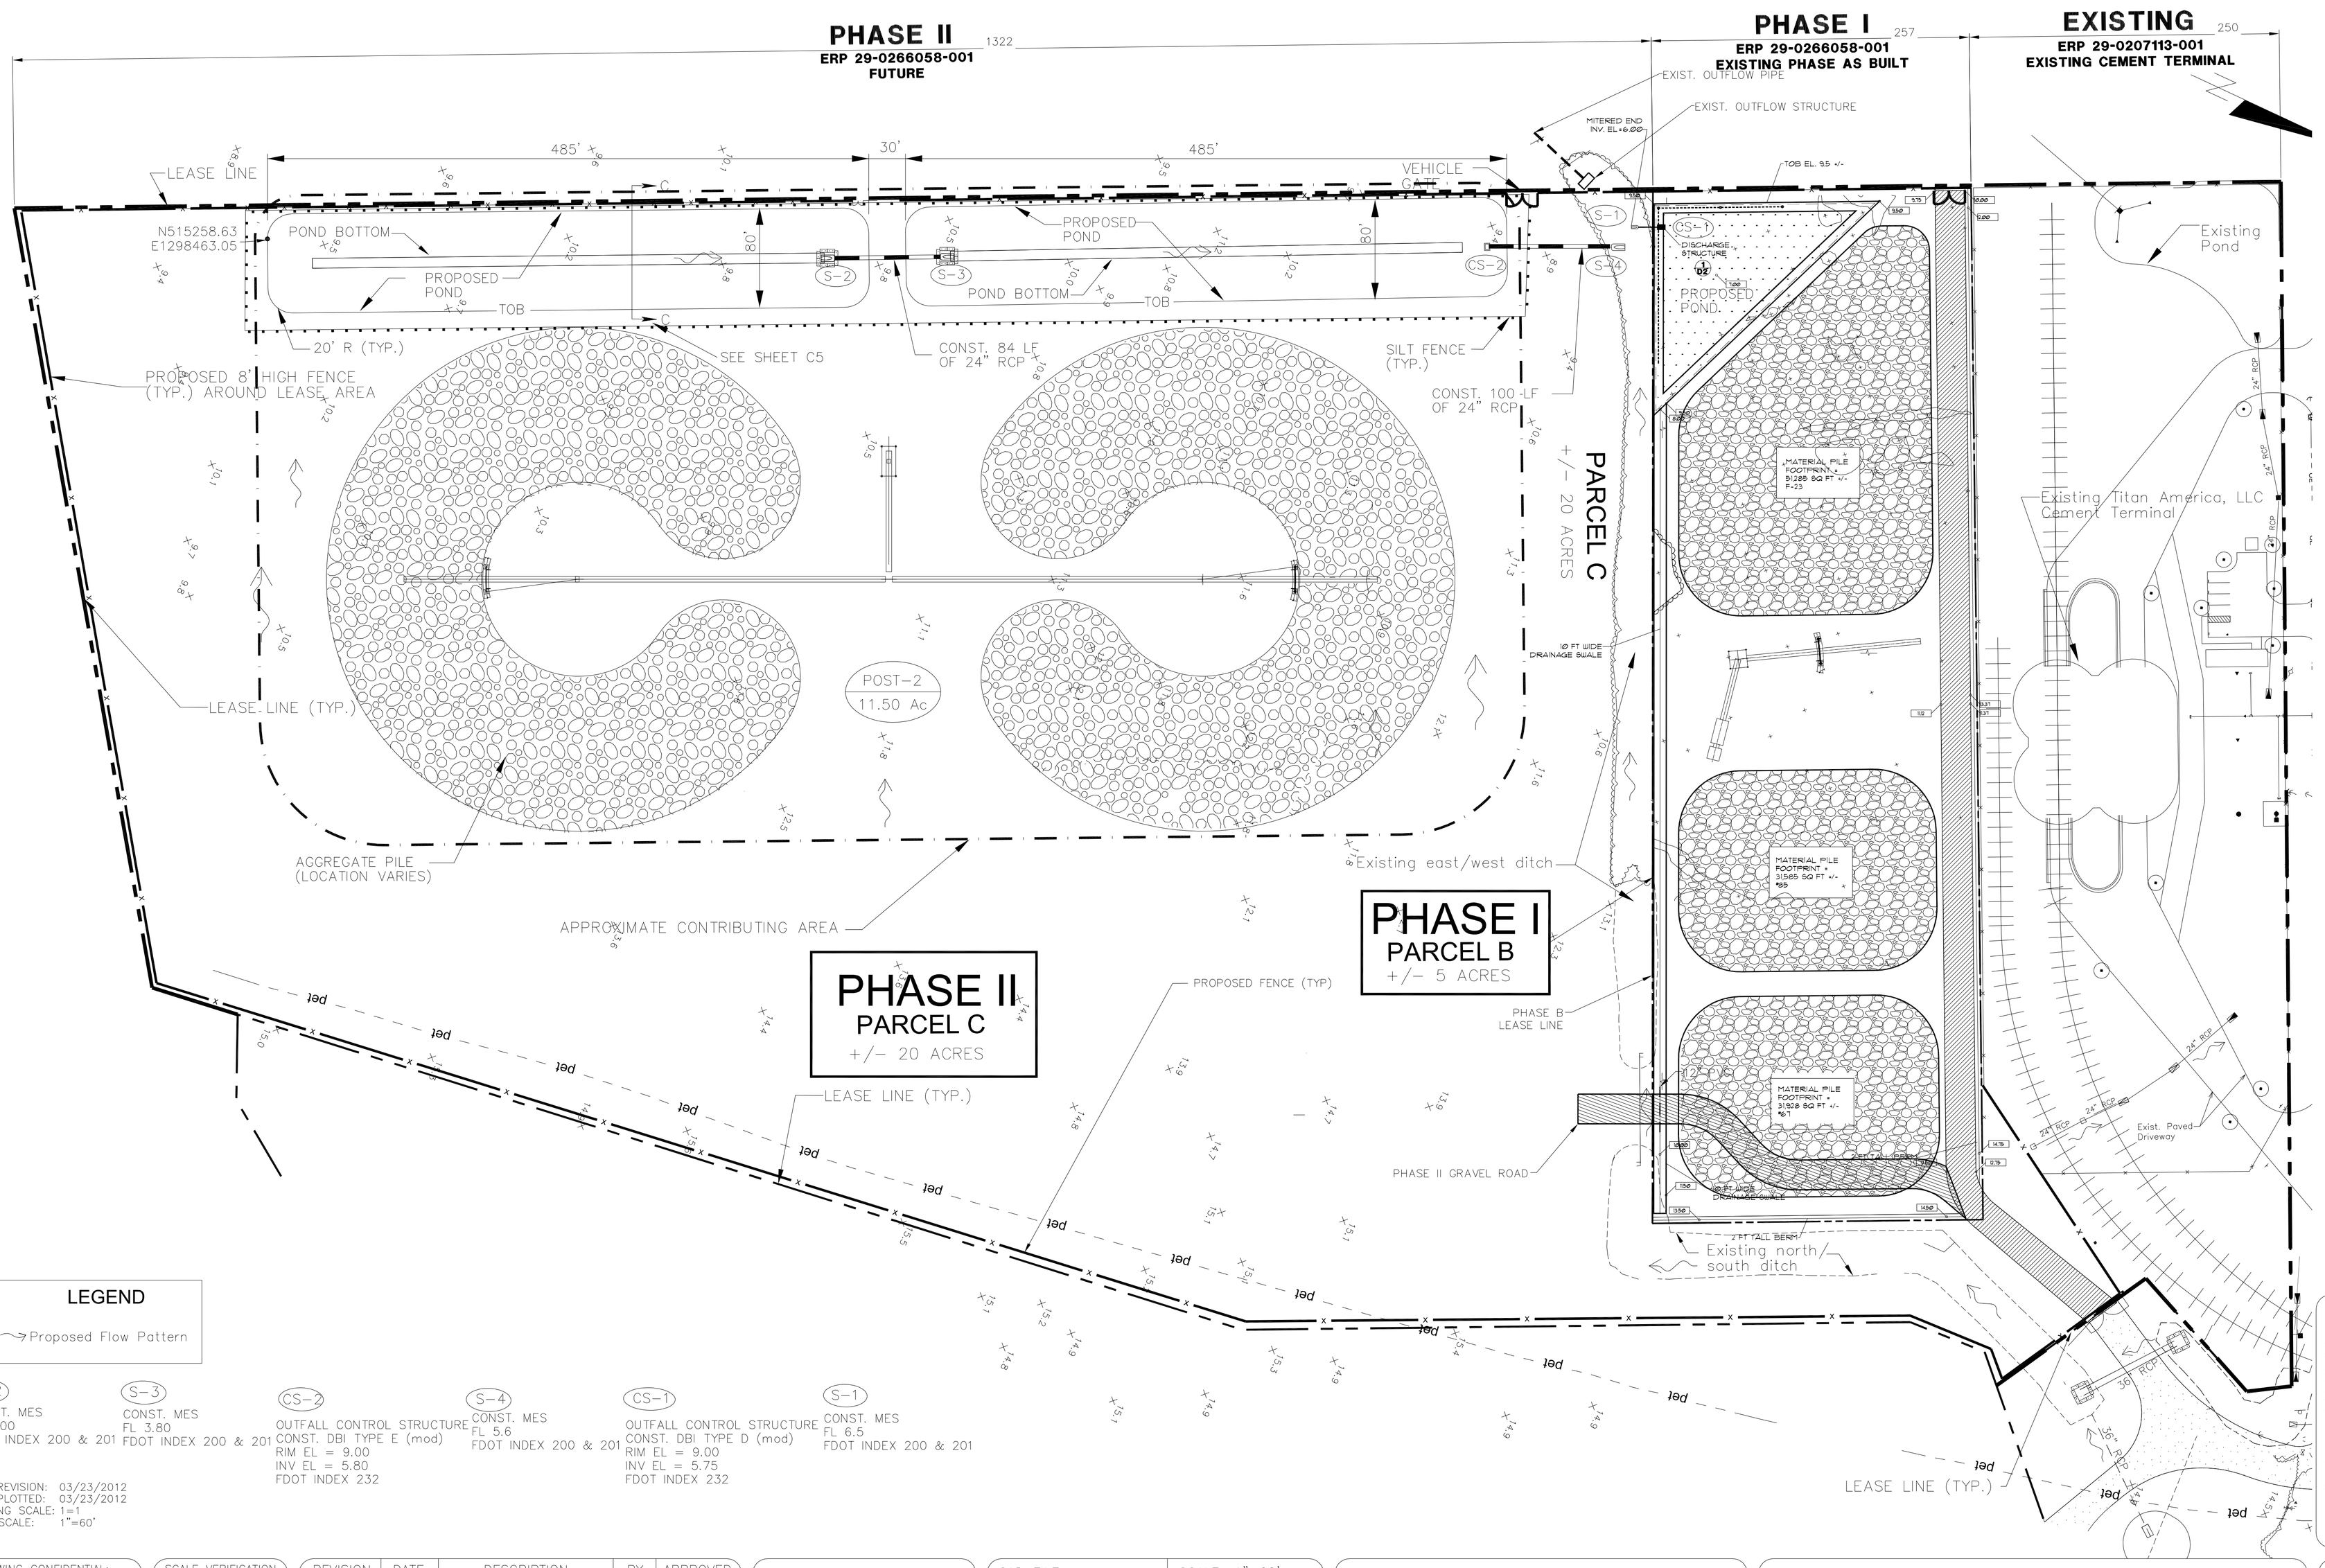

LAST REVISION: 03/23/2012
LAST PLOTTED: 03/23/2012
DRAWING SCALE: 1=1
PLOT SCALE: 1"=60'

AS-BUILT DRAWINGS
I, hereby, certify that these "As-Built Drawings" reflect all significant changes and addenda approved during the construction of the project and that these and the Shop Drawings and other information furnished to the Engineer of Record are accurate to the best of my construction to the best of my knowledge and belief.
ENGINEER: _____ DATE: _____

DRAWING CONFIDENTIAL: THIS DRAWING AND ALL INFORMATION CONTAINED THEREON IS AND SHALL REMAIN THE PROPERTY OF A. ANDREANSKY, P.E. AS AN INSTRUMENT OF PROFESSIONAL SERVICE. THIS INFORMATION SHALL NOT BE USED WITHOUT THE FULL KNOWLEDGE AND PRIOR WRITTEN CONSENT OF AL ANDREANSKY, P.E.

SCALE VERIFICATION: THIS BAR REPRESENTS ONE INCH ON THE ORIGINAL DRAWING. 0 — 1". USE TO VERIFY FIGURE

REVISION	DATE	DESCRIPTION	BY	APPROVED

ENGINEER OF RECORD:
AL ANDREANSKY, P.E. FLA. REG. #39387
DATE SIGNED:

CAD FILE: 11082901ABL	SCALE: 1"=60'
DRAWN BY: A.A.	DATE: 10-14-11
CHECKED BY:	DATE:
APPROVED BY:	DATE:

AL ANDREANSKY, P.E.
P.O. BOX 456
PALM HARBOR, FLORIDA 34682-0456
PHONE: (727) 460-8612, FAX: (727) 789-9565

PHASING LAYOUT
MARITIME BLVD
TAMPA, FLORIDA

PROJECT No. 11082901.001
SHEET L2 of 2

TITAN-TAMPA AGGREGATE UNLOADING FACILITY, TITAN AMERICA, DEERFIELD BEACH, FLORIDA